


CABLE RUN LOCATION BETWEEN FLOORS

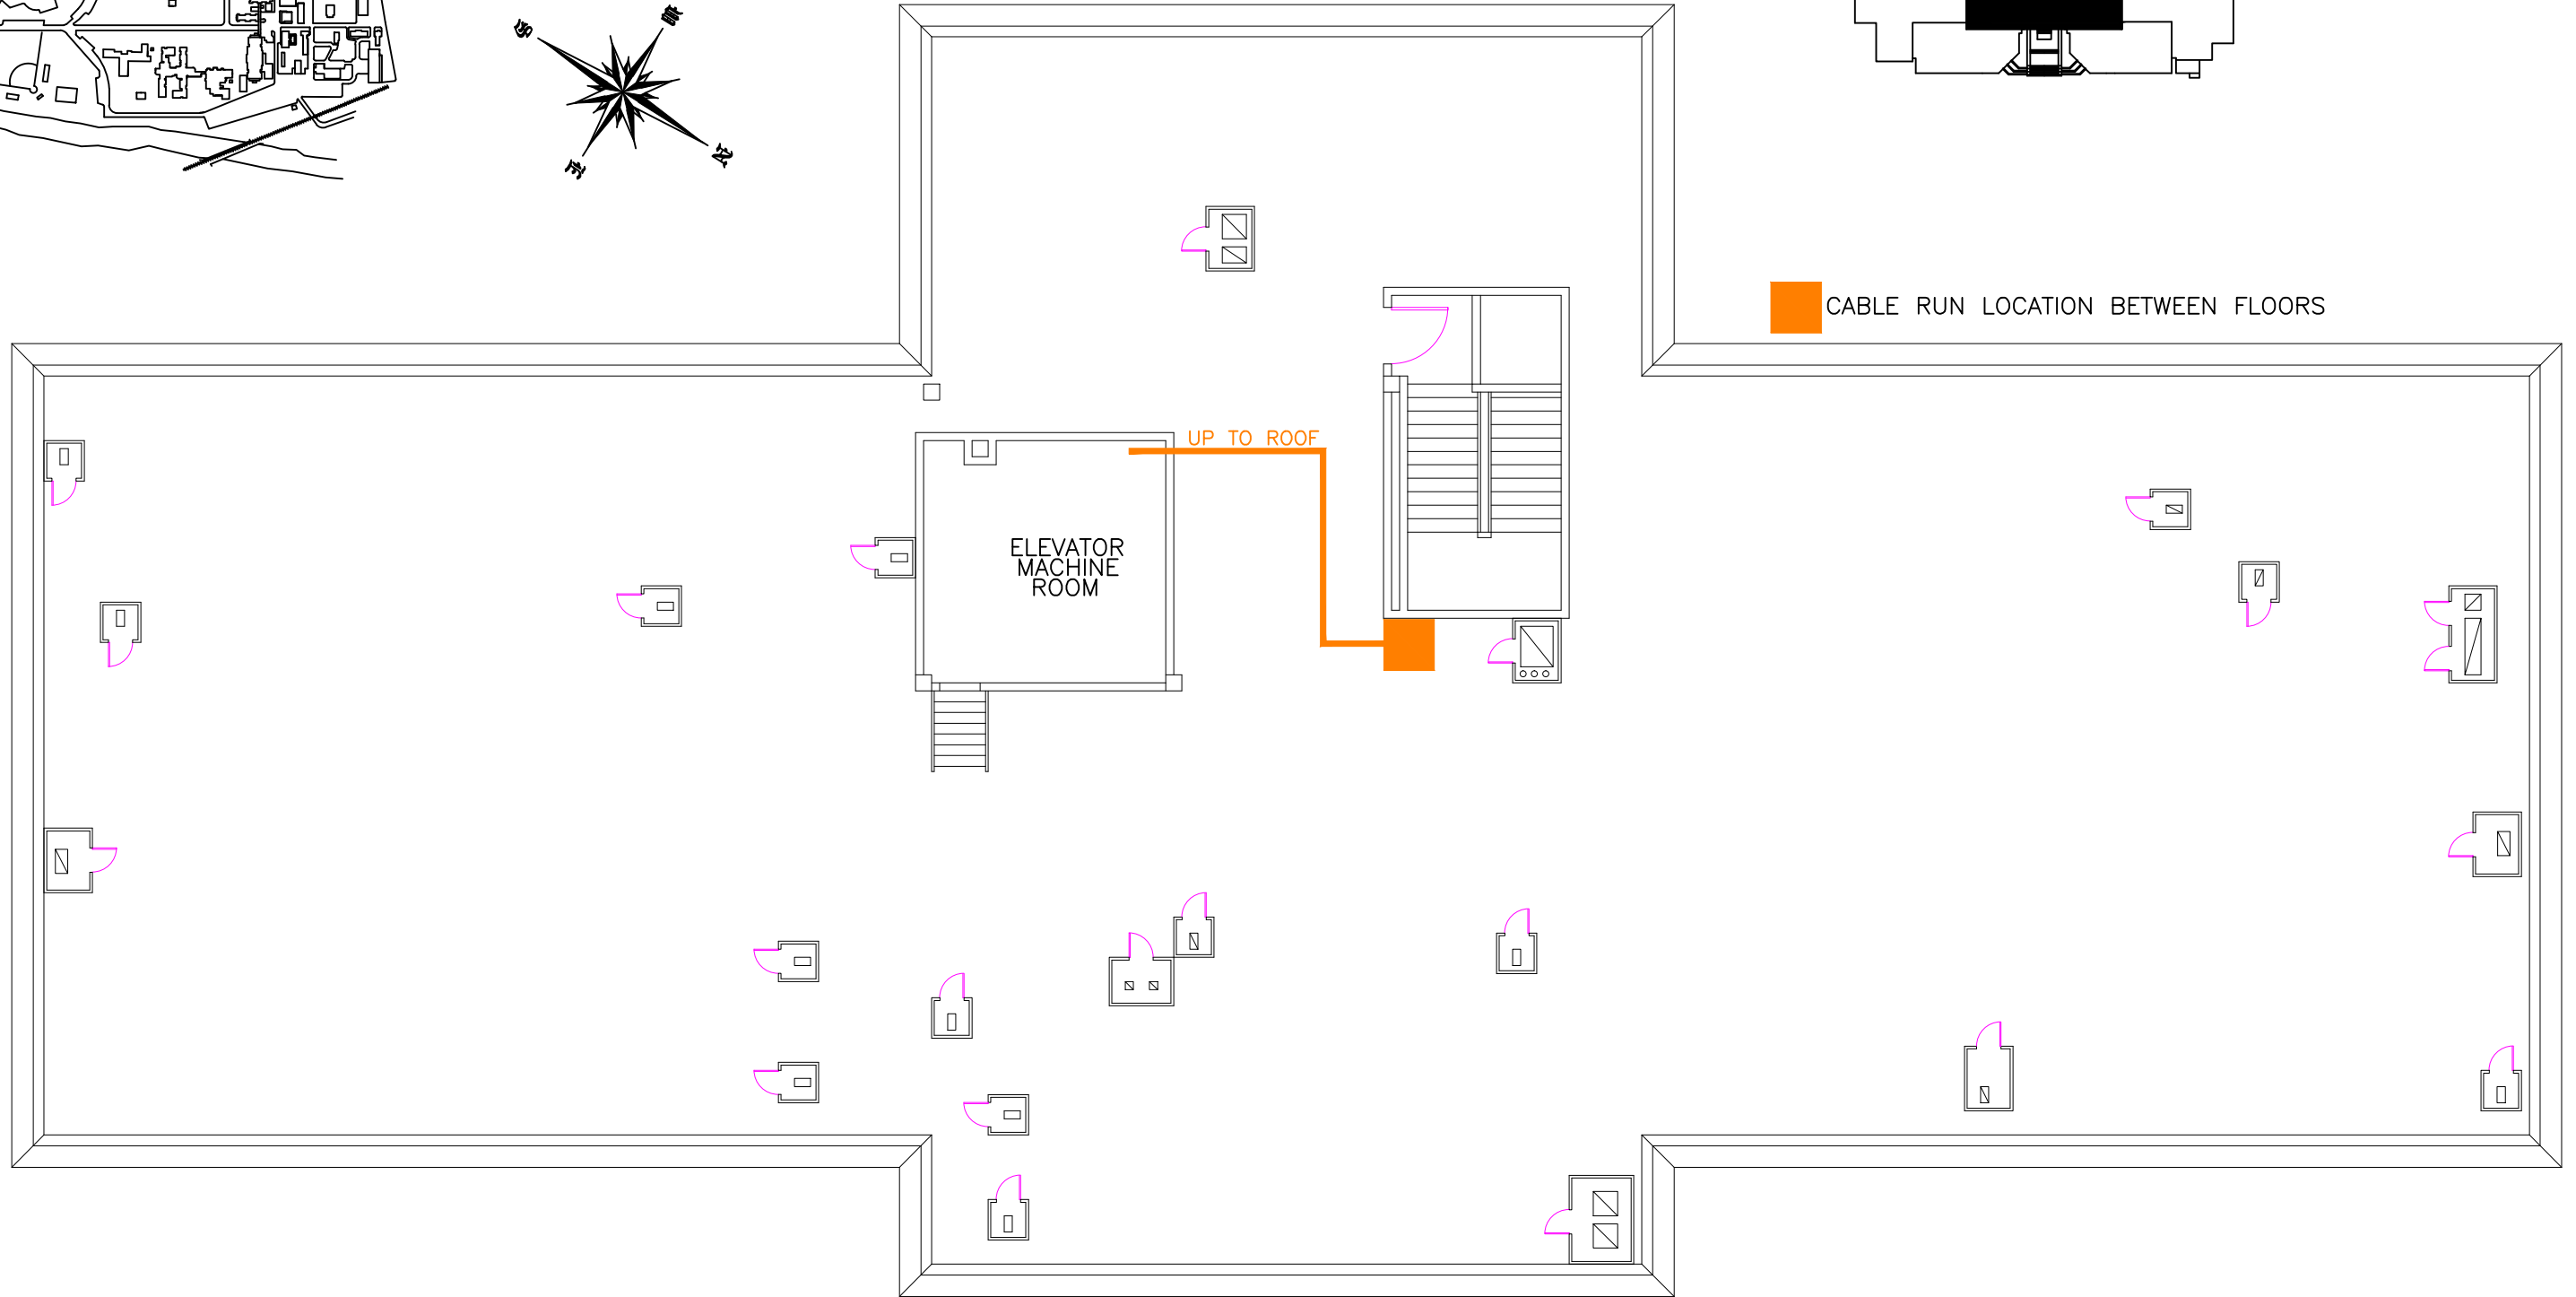

NOTE:  
USERS OF THESE AS-BUILT DRAWINGS ARE  
RESPONSIBLE FOR VERIFYING EXISTING  
DIMENSIONS AND CONDITIONS IN THE FIELD

SCALE: 3/32" = 1'

Drawing Title  
FLOOR PLAN  
SEVENTH FLOOR  
Drawing File Number:

Approved: Project Section Manager

Approved: Medical Center Director

Project Title  
TV SIGNAL CONTRACT

Building No.  
76

Location  
BATH, NEW YORK

Date  
05-09-16

Project No.

DRAWING NO.

Dwg. 1 Of 1

Revisions	Date